


DWELLING ONE – GROUND FLOOR AS BUILT

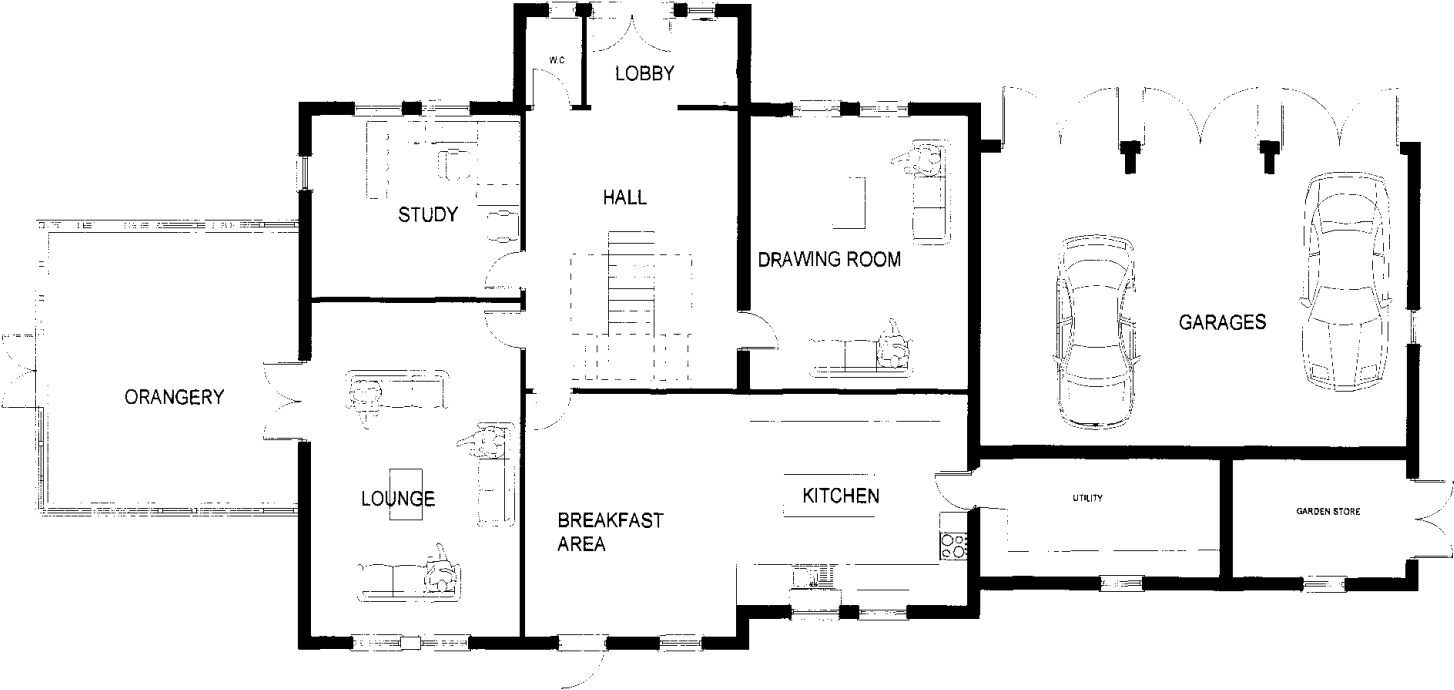

Dwelling One - Proposed Ground Floor Plan ( scale 1:100 )

- REV 'F' AS-BUILT REVISIONS 30--1-08
- REV 'E' AS-BUILT REVISIONS 30--7-07
- REV 'D' REVISED FLOOR PLAN 26-6-06
- REV 'C' REVISED FLOOR PLAN 28-4-06
- REV 'B' REVISED FLOOR PLAN 14-2-06
- REV 'A' REVISED TO PLANNING OFFICERS COMMENTS 21-9-05

1st August 2007

**Sean McLean Design**  
 The Studio, 25 St.Aidan's Crescent, Billingham, TS22 5AD  
 Tel / Fax : 01642 555110 E-mail smdesign@tiscali.co.uk

---

PROPOSED REPLACEMENT DWELLINGS  
 AT BISHOPSGARTH COTTAGES, DARLINGTON  
 BACK LANE, STOCKTON FOR MR.M.FAROUC


---

DWELLING ONE  
 PROPOSED GROUND FLOOR PLAN

---

Drg. No. 0567 / 02 F Date July 05

DWELLING ONE – FIRST FLOOR AS BUILT

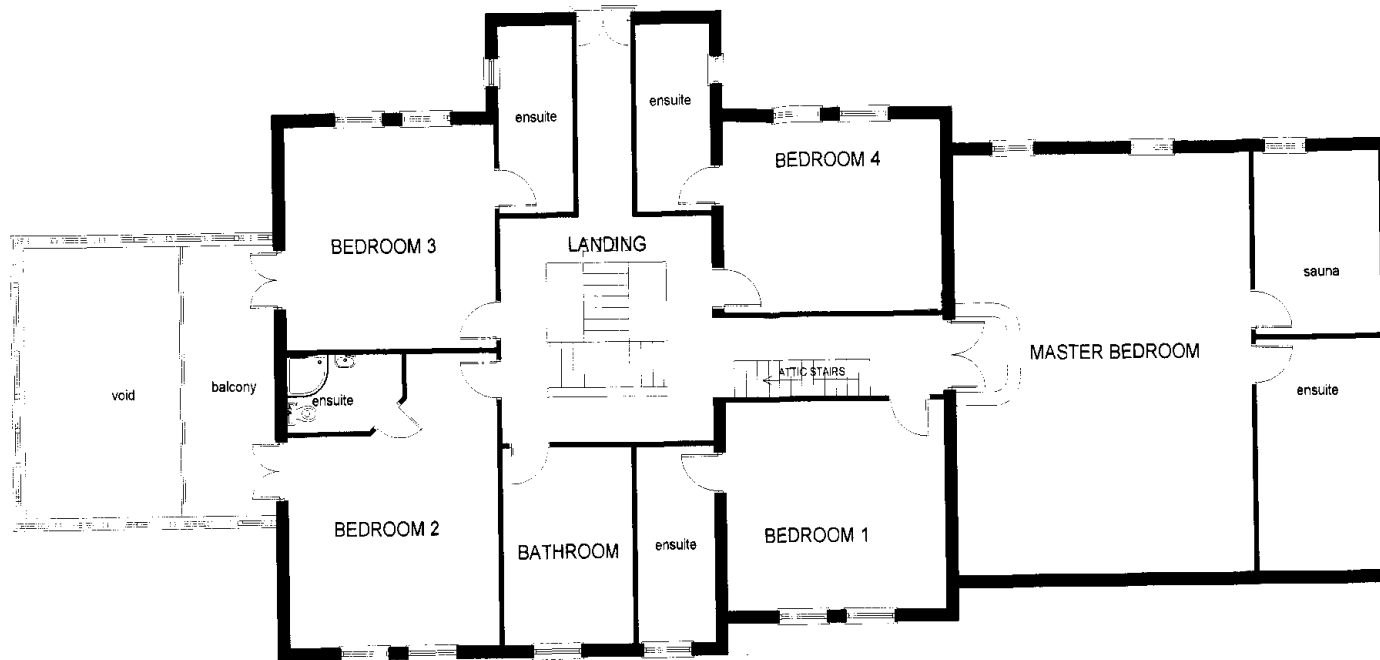

Dwelling One - Proposed First Floor Plan ( scale 1:100 )

- REV 'E' AS-BUILT REVISIONS 30--1-08
- REV 'D' AS-BUILT REVISIONS 30--7-07
- REV 'C' REVISED FLOOR PLAN 28-4-06
- REV 'B' REVISED FLOOR PLAN 14-2-06
- REV 'A' REVISED TO PLANNING OFFICERS COMMENTS 21-9-05

**Sean McLean Design**

The Studio, 25 St.Aidan's Crescent, Billingham, TS22 5AD  
Tel / Fax : 01642 555110 E-mail smdesign@tiscali.co.uk


PROPOSED REPLACEMENT DWELLINGS  
AT BISHOPSGARTH COTTAGES, DARLINGTON  
BACK LANE, STOCKTON FOR MR.M.FAROUC

*1st August 2007*

DWELLING ONE  
PROPOSED FIRST FLOOR PLAN


Drg. No. 0567 / 03 E Date July 05

DWELLING ONE – ATTIC ROOMS AS BUILT

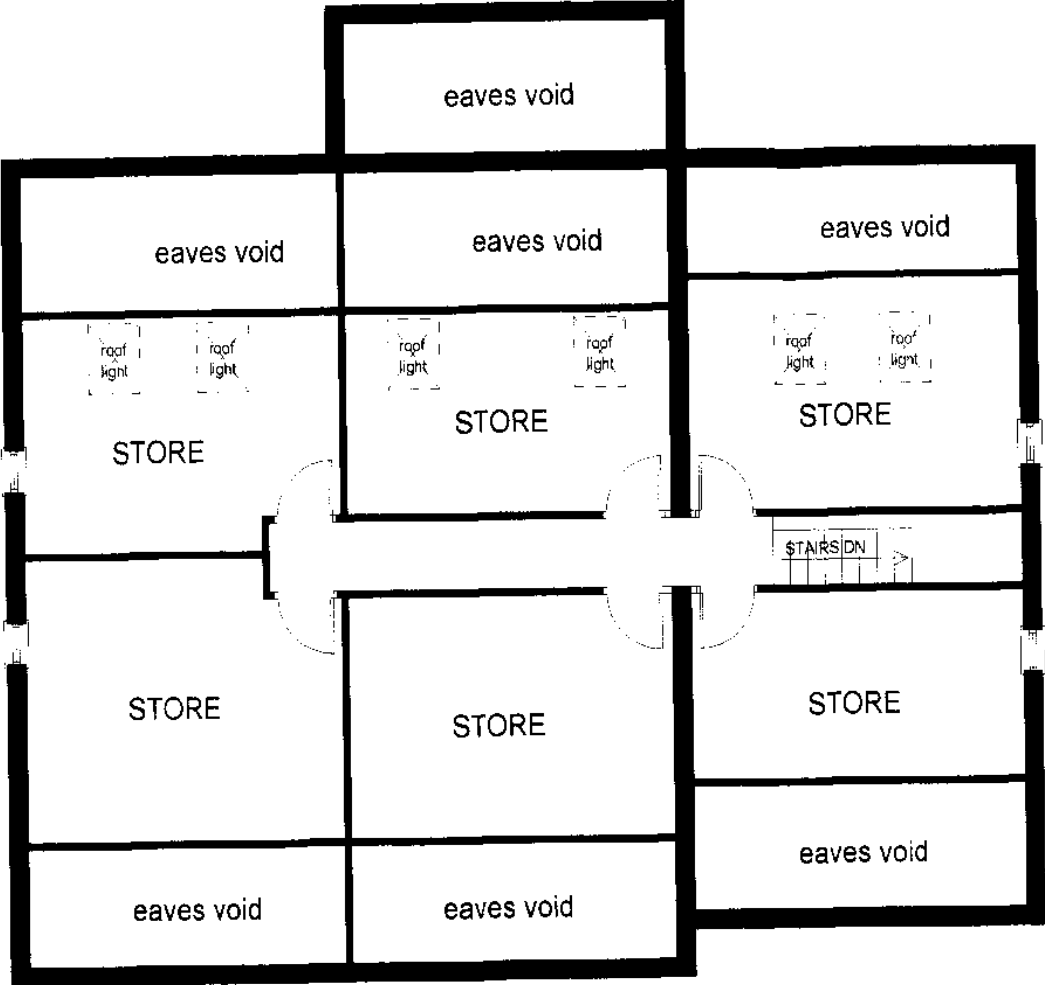

Dwelling One - Proposed Attic Floor Plan ( scale 1:100 )

**DWELLING TWO – GROUND FLOOR AND FIRST FLOOR AS BUILT**

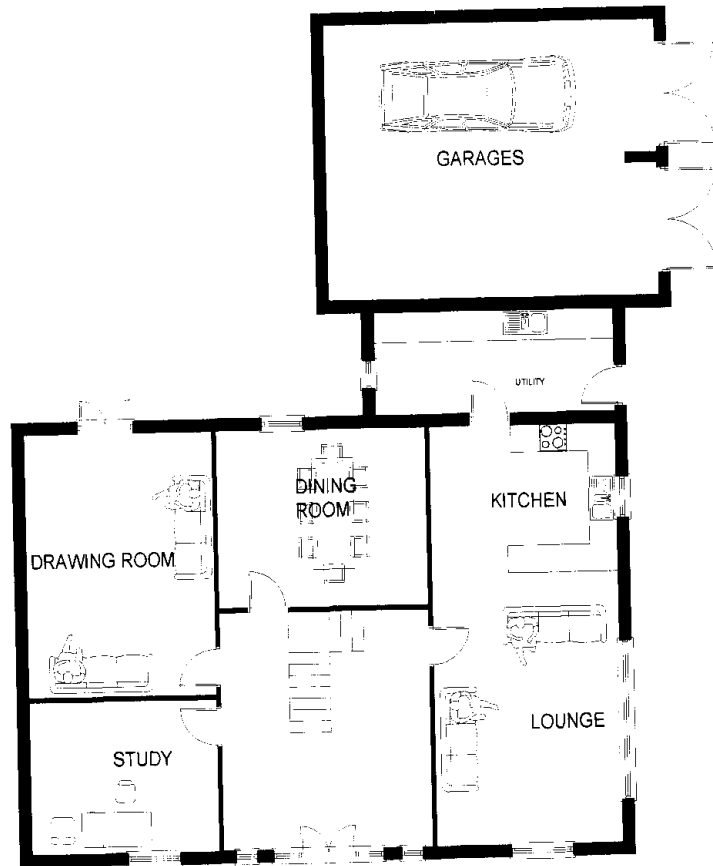

Dwelling Two - Proposed Ground Floor Plan ( scale 1:100 )



Dwelling Two - Proposed First Floor Plan ( scale 1:100 )

STOCKTON FOR MR. M. FAROUQ  
 DEPOSITED  
 1st August 07  
 SUPERSEDES PLAN DATED  
 HEAD OFFICE, SHEFFY

**Sean McLean Design**

The Studio, 25 St. Aidan's Crescent, Billingham, TS22 5AD  
 Tel / Fax : 01642 555110 E-mail smdesign@tiscali.co.uk

PROPOSED REPLACEMENT DWELLINGS  
 AT BISHOPSGARTH COTTAGES, DARLINGTON  
 BACK LANE, STOCKTON FOR MR. M. FAROUQ

**DWELLING TWO  
 PROPOSED FLOOR PLANS**

Drg. No. 0567 / 06 E Date July 05

DWELLING TWO – ATTIC ROOMS AS BUILT



Dwelling Two - Proposed Attic Floor Plan ( scale 1:100 )