



**Appendix reference 8. DWELLING TWO -(East or Side Elevation)
DIFFERENCES BETWEEN AS BUILT, AS PROPOSED AND AS APPROVED PLANS**

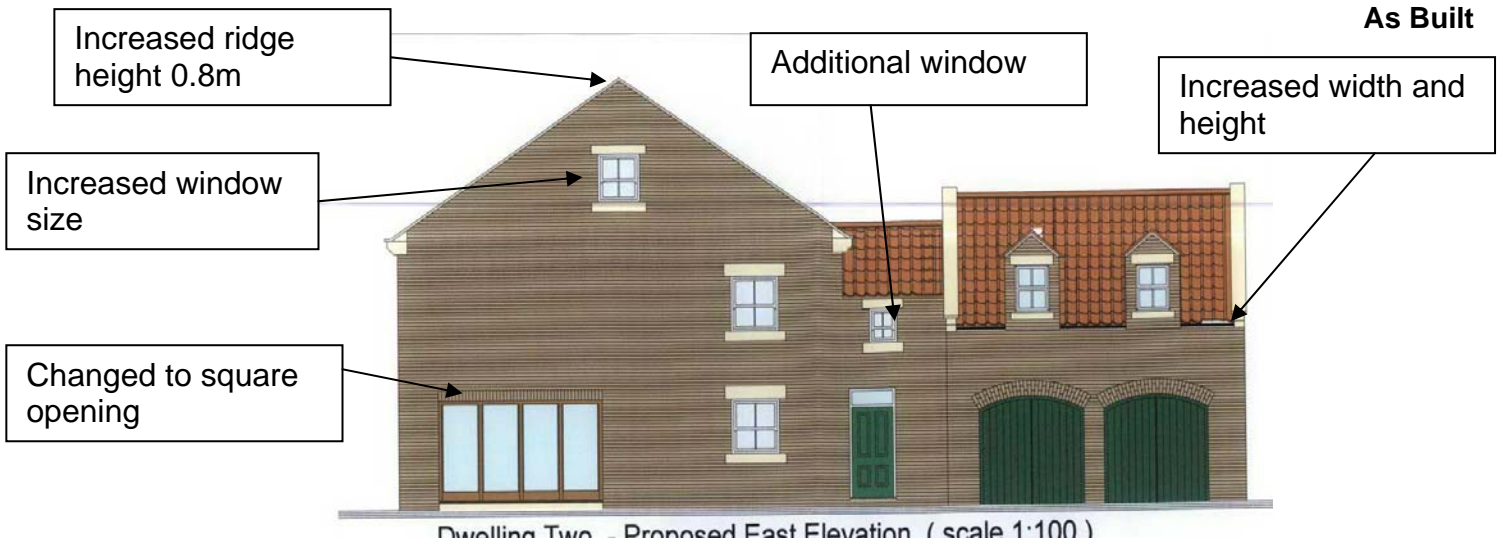

07/2319/ARC Submission

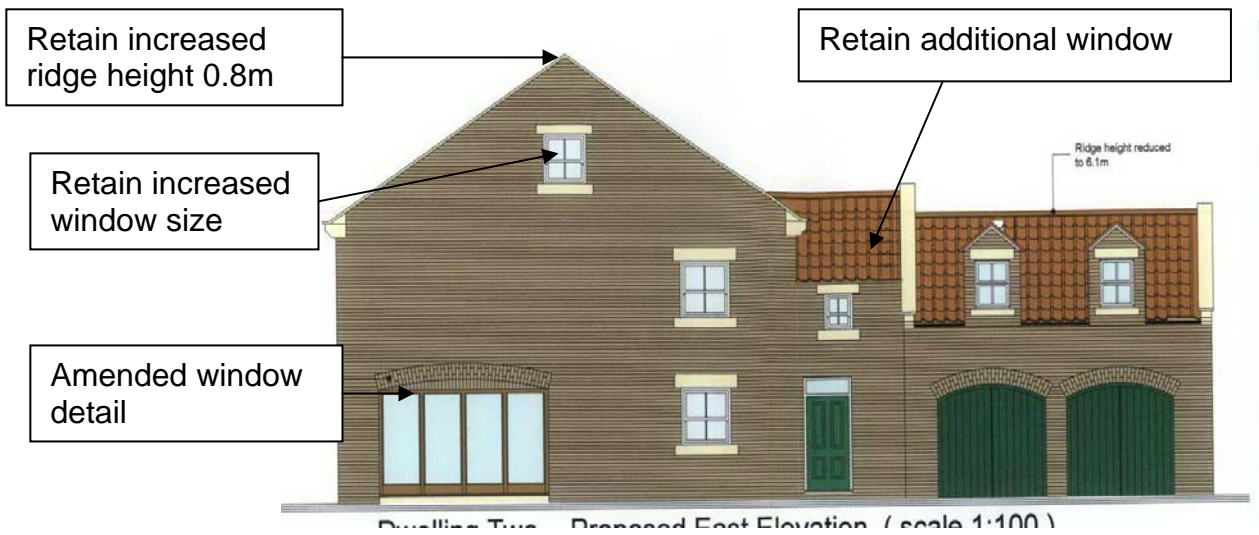


As approved




**Appendix reference 9. DWELLING TWO -(West or Side Elevation)
DIFFERENCES BETWEEN AS BUILT, AS PROPOSED AND AS APPROVED PLANS**

As Built

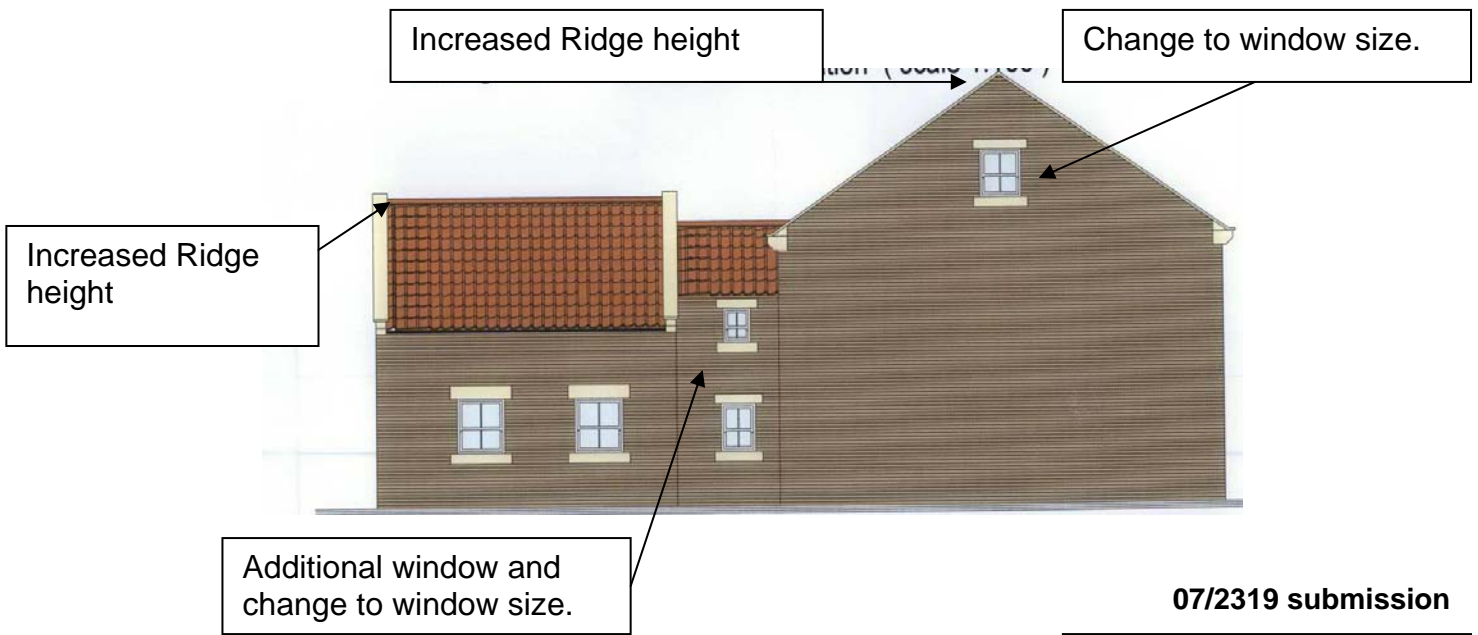

07/2319 submission

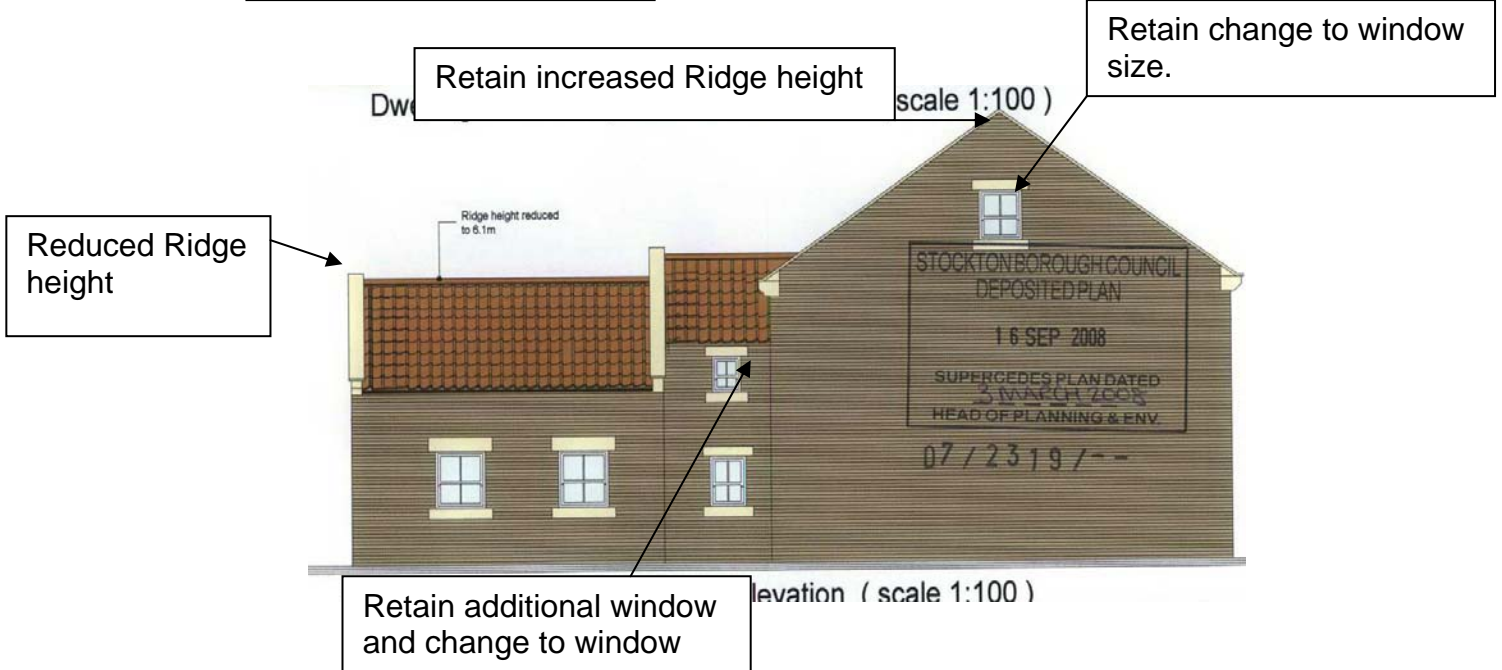


As approved




**Appendix reference 10. DWELLING ONE -(Floor Plans)
DIFFERENCES BETWEEN AS BUILT, AS PROPOSED AND AS APPROVED PLANS**

DWELLING ONE – GROUND FLOOR AS BUILT

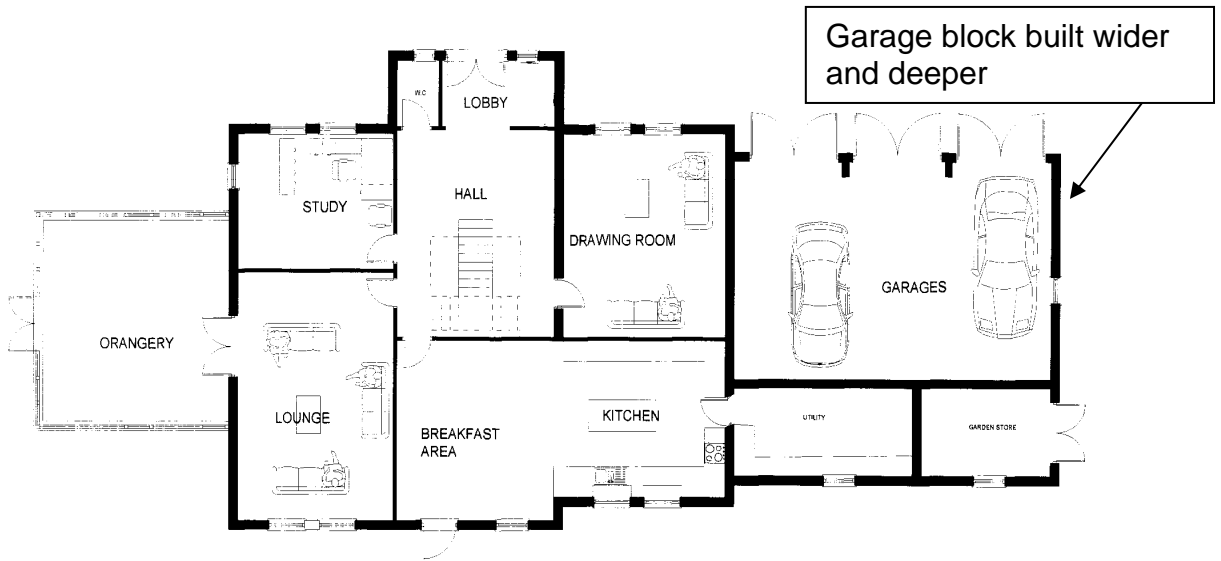

DWELLING ONE – GROUND FLOOR AS PROPOSED 07/2319/ARC

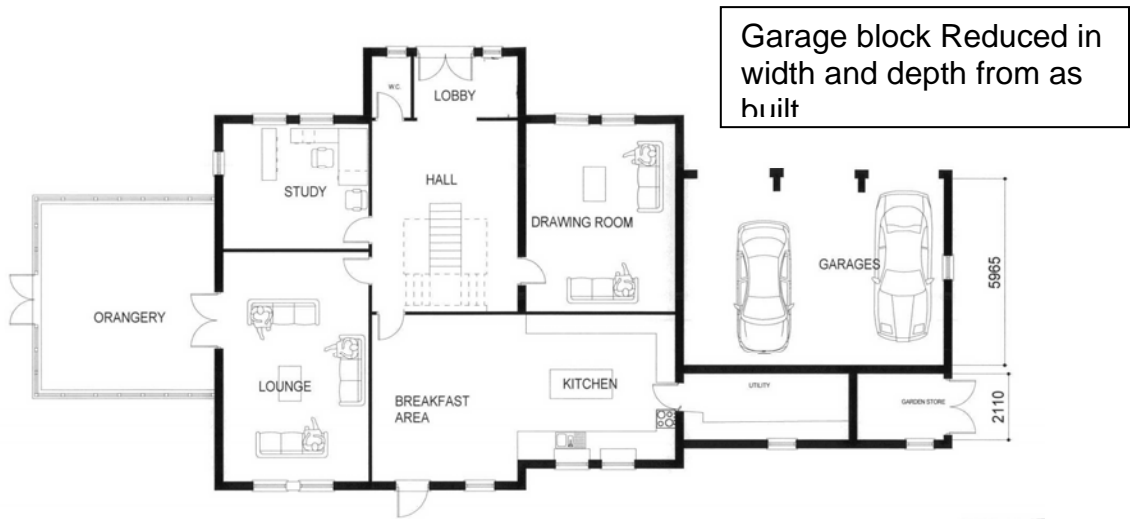

STOCKTON BROS


DWELLING ONE – GROUND FLOOR AS APPROVED




REV 'D' REVISED FLOOR PLAN 26-6-0

**Appendix reference 11. DWELLING ONE -(Floor Plans)
DIFFERENCES BETWEEN AS BUILT, AS PROPOSED AND AS APPROVED PLANS**

DWELLING ONE – FIRST FLOOR AS BUILT

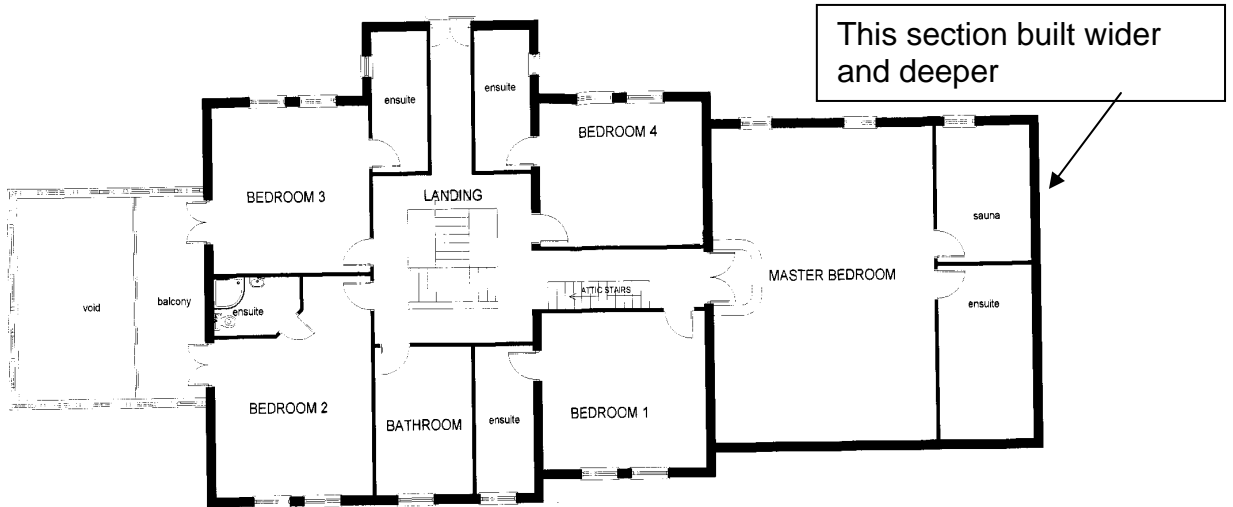

DWELLING ONE – FIRST FLOOR AS PROPOSED 07/2319/ARC

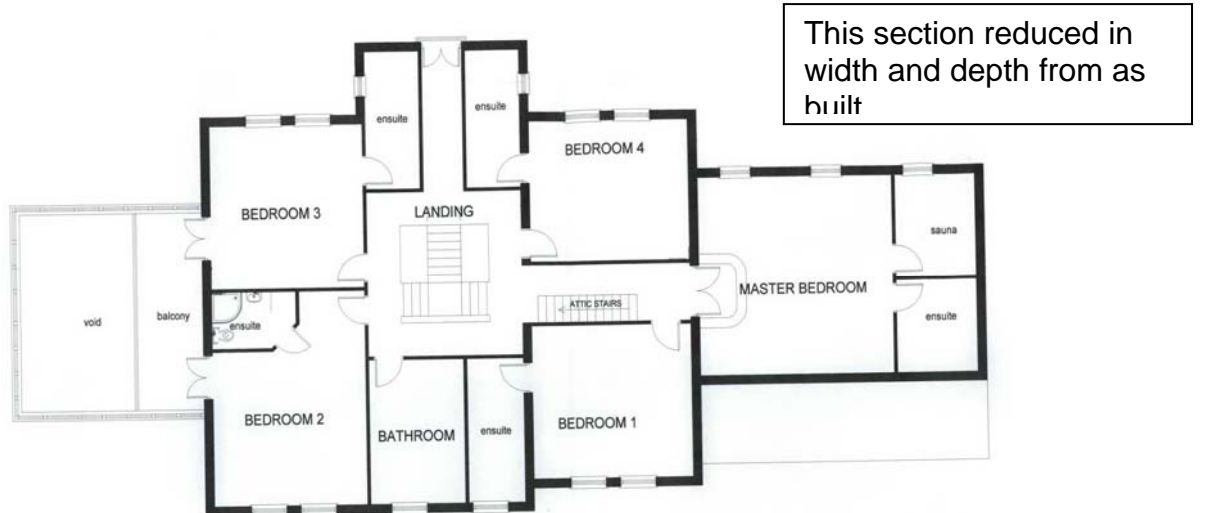


DWELLING ONE – FIRST FLOOR AS APPROVED




REVISED FLOOR PLAN

**Appendix reference 12. DWELLING ONE -(Floor Plans)
DIFFERENCES BETWEEN AS BUILT, AS PROPOSED AND AS APPROVED PLANS DWELLING ONE**

ATTIC ROOMS AS BUILT

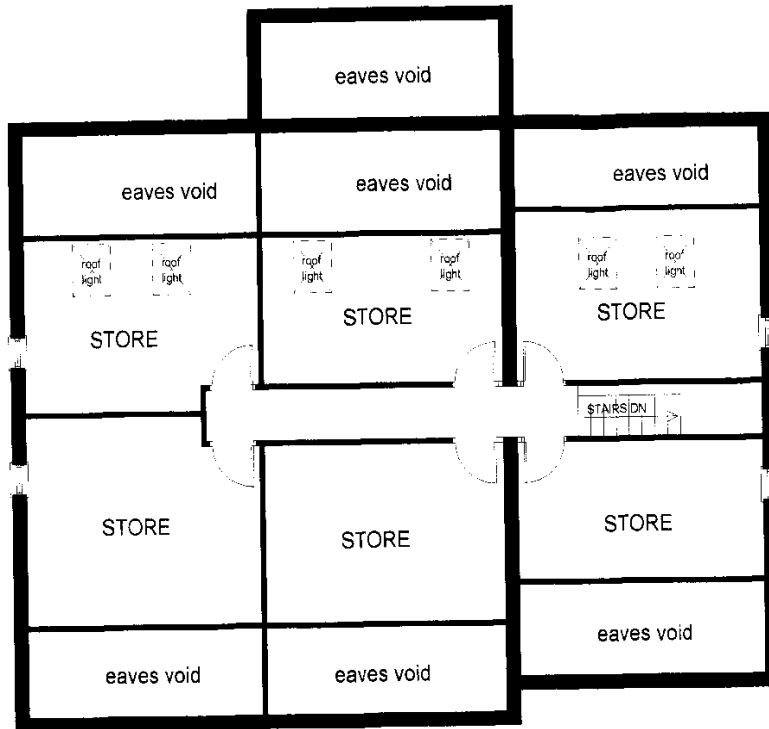


ATTIC ROOMS AS PROPOSED 07/2319/ARC

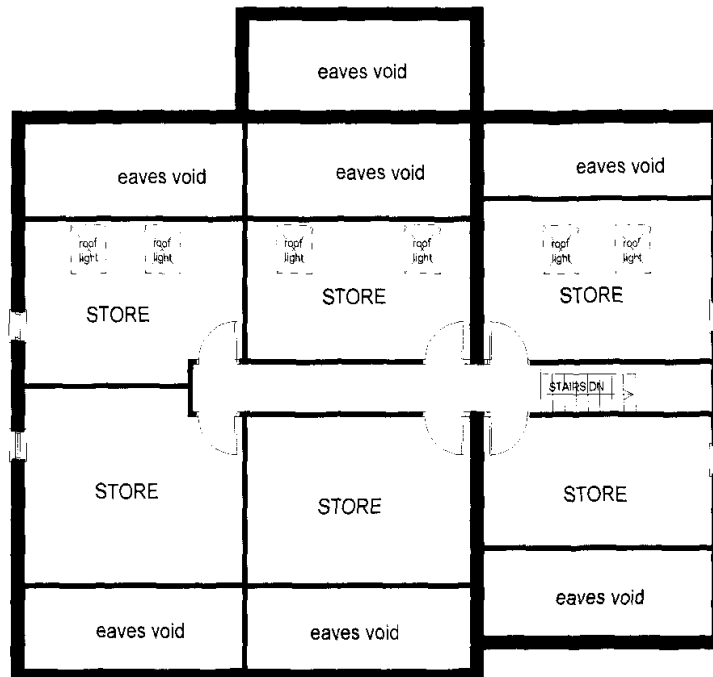

APPROVED SCHEME – THERE WERE NO ATTIC ROOMS APPROVED UNDER PREVIOUS SCHEMES

**Appendix reference 13. DWELLING TWO -(Floor Plans)
DIFFERENCES BETWEEN AS BUILT, AS PROPOSED AND AS APPROVED PLANS**

AS BUILT - GROUND FLOOR AND FIRST FLOOR

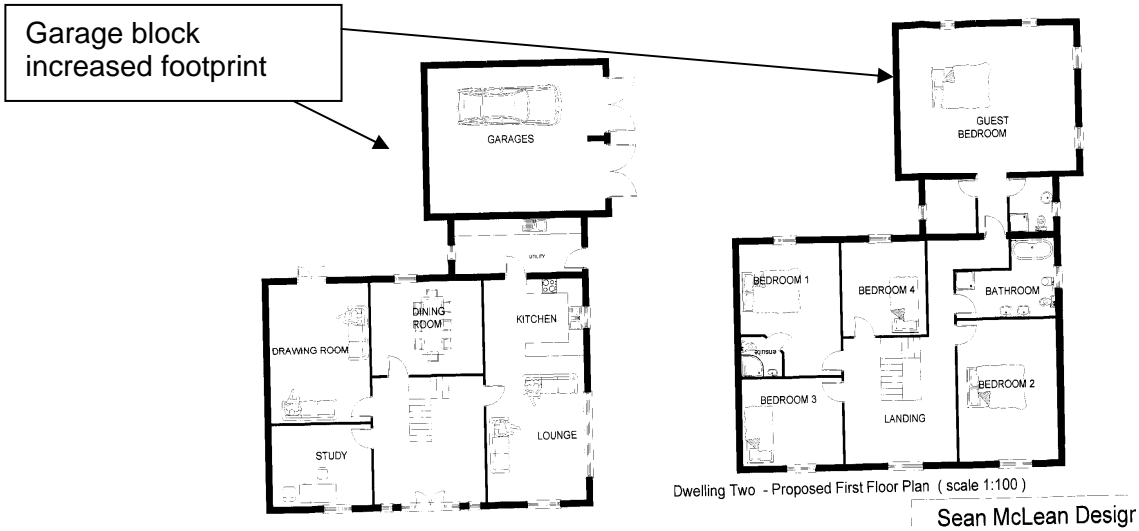

AS PROPOSED 07/2319/ARC - GROUND FLOOR AND FIRST FLOOR PLANS




AS APPROVED - GROUND AND FIRST FLOOR PLANS




**Appendix reference 14. DWELLING TWO - (Floor Plans)
DIFFERENCES BETWEEN AS BUILT, AS PROPOSED AND AS APPROVED PLANS**

ATTIC ROOMS AS BUILT

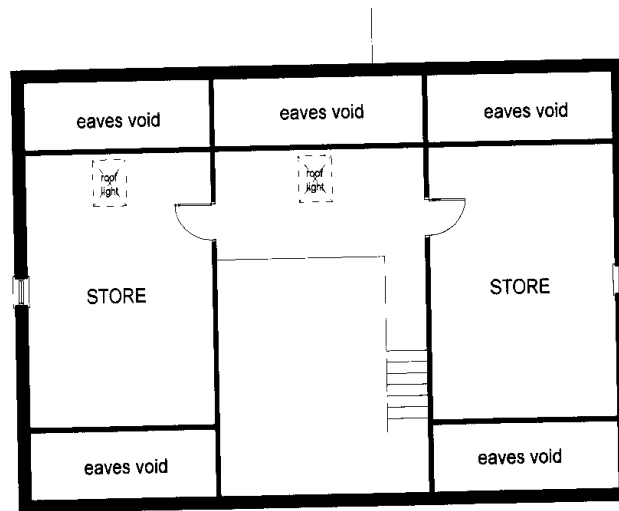

DWELLING TWO – ATTIC ROOMS AS PROPOSED 07/2319/ARC

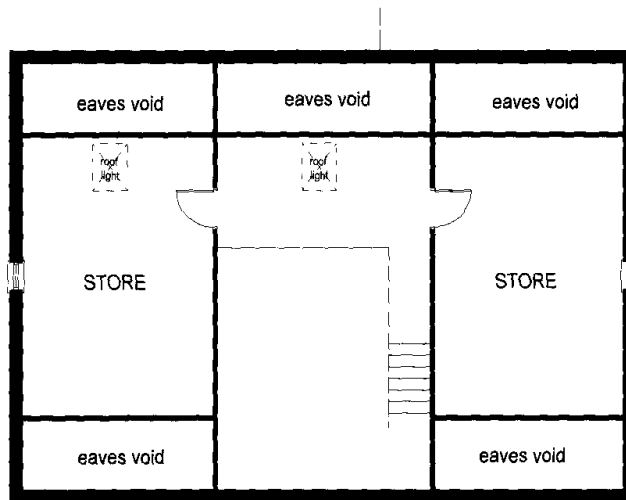

APPROVED SCHEME – THERE WERE NO ATTIC ROOMS APPROVED UNDER PREVIOUS SCHEMES