




AS BUILT FRONT WALL ELEVATION
SCALE 1:100

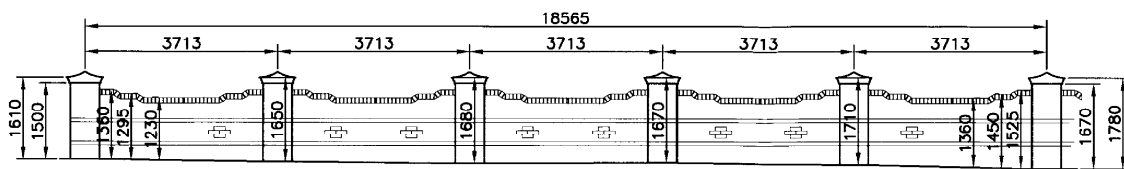


AS BUILT SIDE WALL ELEVATION
SCALE 1:100

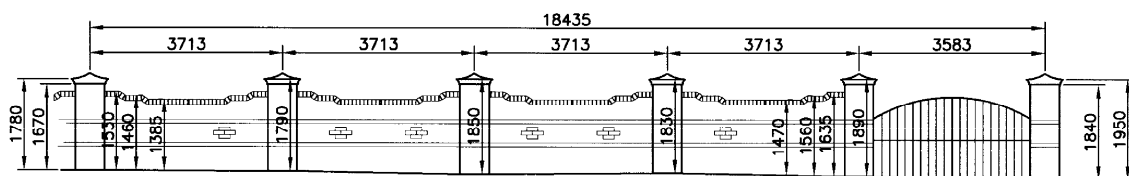

AS BUILT SIDE WALL ELEVATION
SCALE 1:100

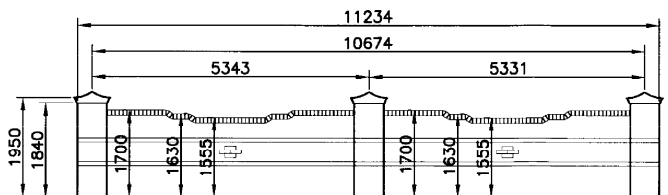

PROPOSED REAR WALL ELEVATION
SCALE 1:100

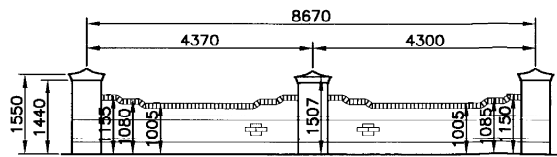

AS BUILT SHARED WALL ELEVATION
SCALE 1:100

STOCKTON-BROUGH COUNCIL
PLANNING
23 MAR 2010
RECEIVED

NOTES

TRADESMEN SHOULD USE SHOWN BRICK PATTERN AS A GUIDE ONLY AND CHECK ALL SETTING OUT DIMENSIONS BEFORE STARTING.

MAIN BRICKS ARE TO MATCH DWELLINGS AND DETAIL BRICKS ARE TO BE BUFF IN COLOUR.

GATE DESIGN TO BE CONFIRMED.

Received 29/3/10

AS BUILT/PROPOSED
BOUNDARY WALL

MR & MRS KHAN
166 BISHOPTON ROAD,
STOCKTON ON TEES.
TS18 4PQ

DRAWING No/CAD FILE
2010/001/02

B									
SCALE	1:100 @ A3				DATE	24 MARCH 10			

P.D.S.

PROFESSIONAL DRAWING SERVICE

DRAWN BY	C.B.	CHECKED		SIG.	
----------	------	---------	--	------	--