


08/2977/FUL
Land North of Blair Avenue, Ingleby Barwick, Stockton-on-Tees
Appendix ref. 5


As Built Care Home Elevations




EAST ELEVATION

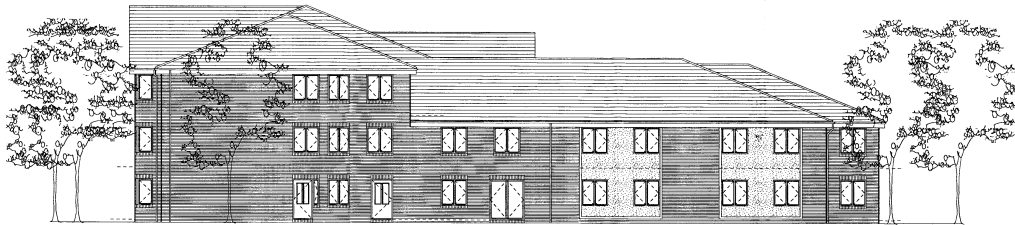

SOUTH ELEVATION

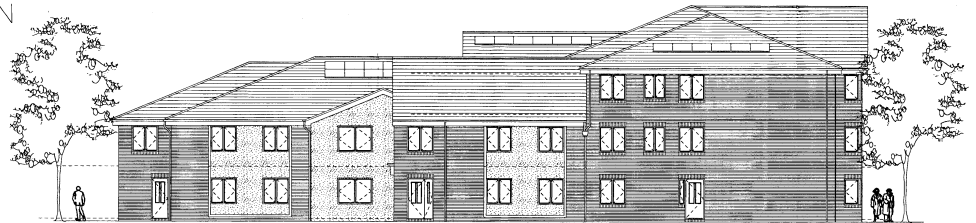

NORTH ELEVATION

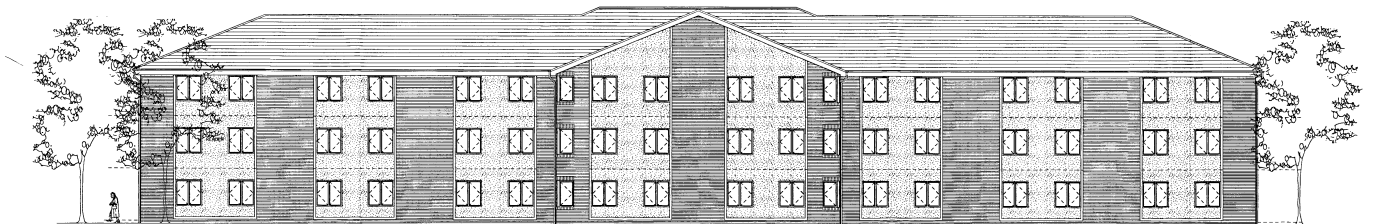

WEST ELEVATION