


# APPENDIX 1 – LOCATION PLAN

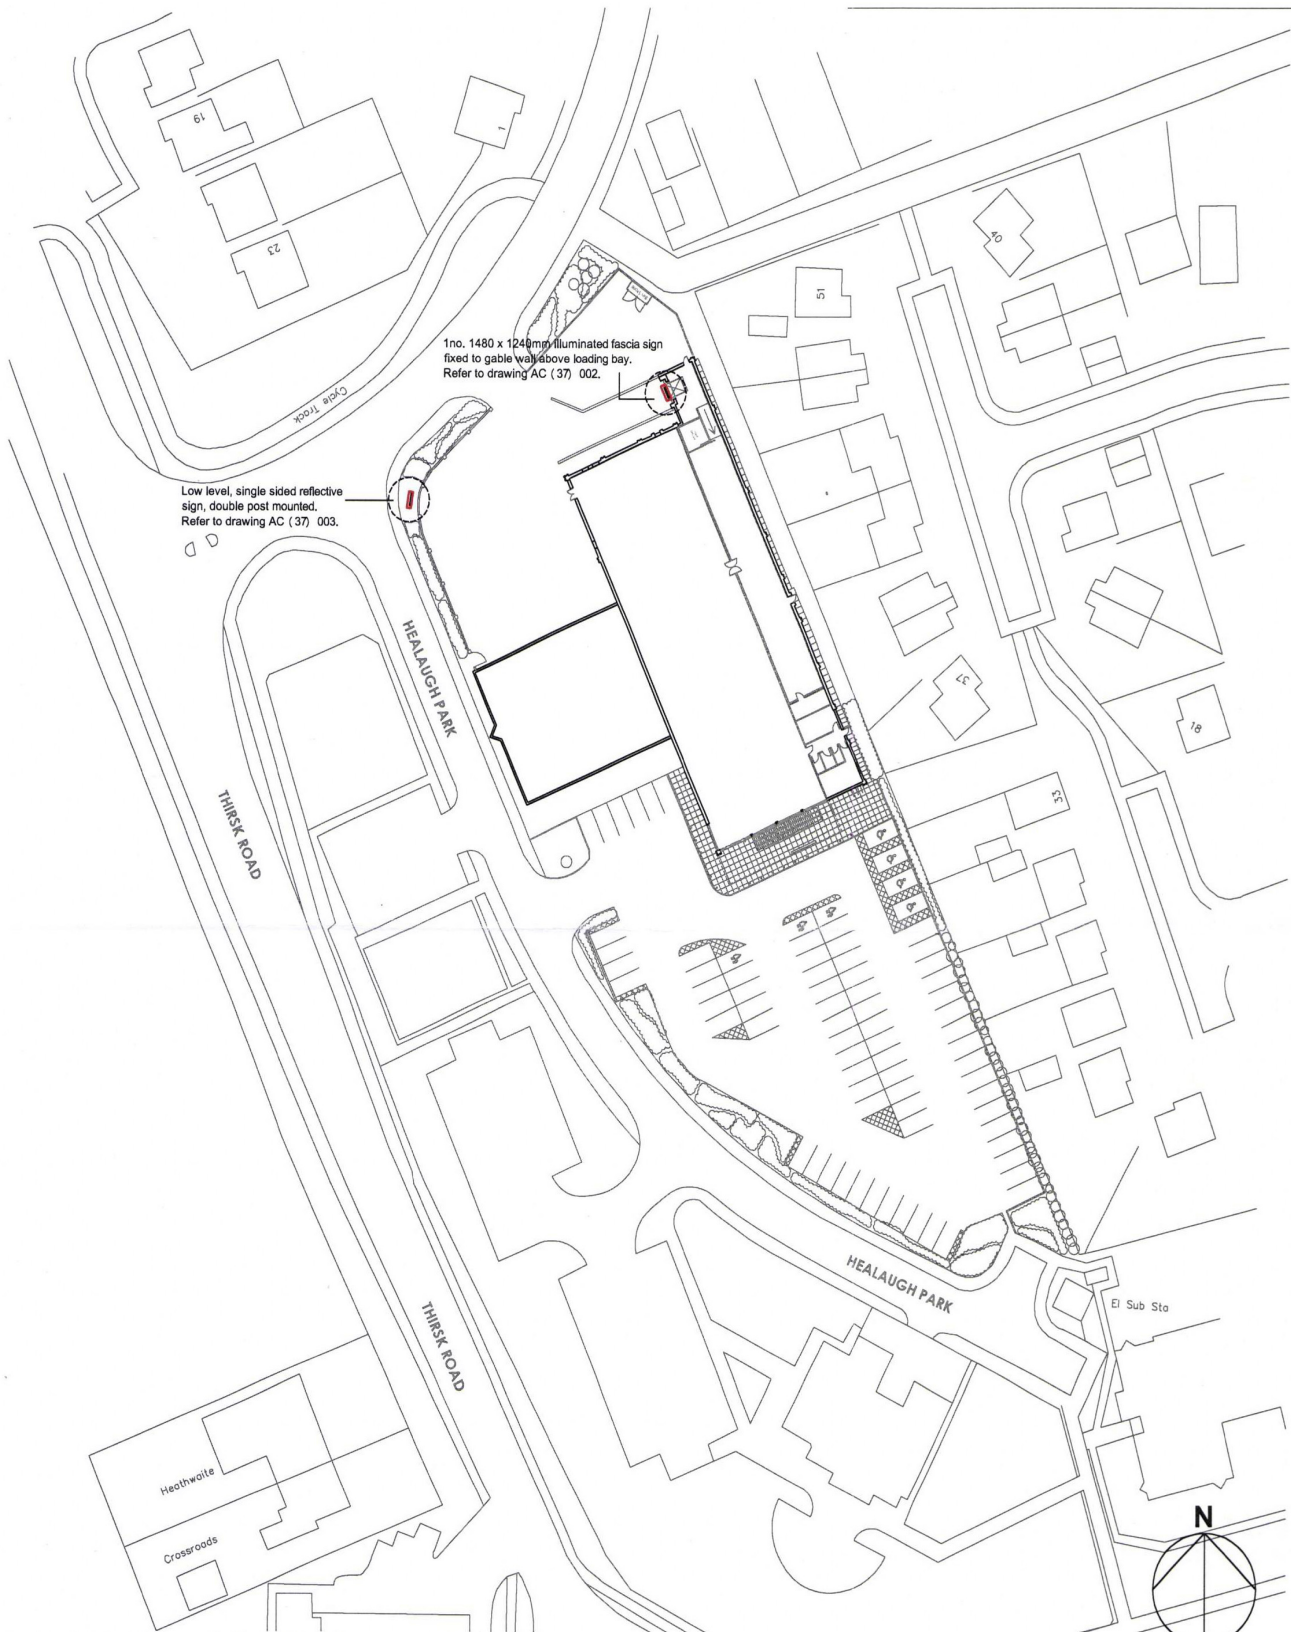

Low level, single sided reflective sign, double post mounted. Refer to drawing AC (37) 003.

1no. 1480 x 1240mm illuminated fascia sign fixed to gable wall above loading bay. Refer to drawing AC (37) 002.

A - Fascia Sign Reduced in Size - 12.04.11  
 B - Signs drawn to scale at request of planners - 21.04.11  
 Red line drawn around signs at request of planners.

Client  
**Aldi Stores Ltd**

Project Address  
**Healaugh Park, Yarm**

Drawn **MJ**  
 Date **22/03/11**



Project  
**Aldi - Yarm**

Drawing Title  
**Signage Location Plan**

Drawing Number  
**0134 - AC(37)001**

Revision  
**B**

**Projekt Architects**  
 57 Lime Street  
 Ouseburn Valley  
 Newcastle Upon Tyne  
 NE1 2PQ

t: 0191 222 1624  
 f: 0191 447 6033

e: admin@projektarchitects.com  
 www.projektarchitects.com

