



Proposed Front Elevation

Scale 1:25 @ A1 & 1:50 @ A3

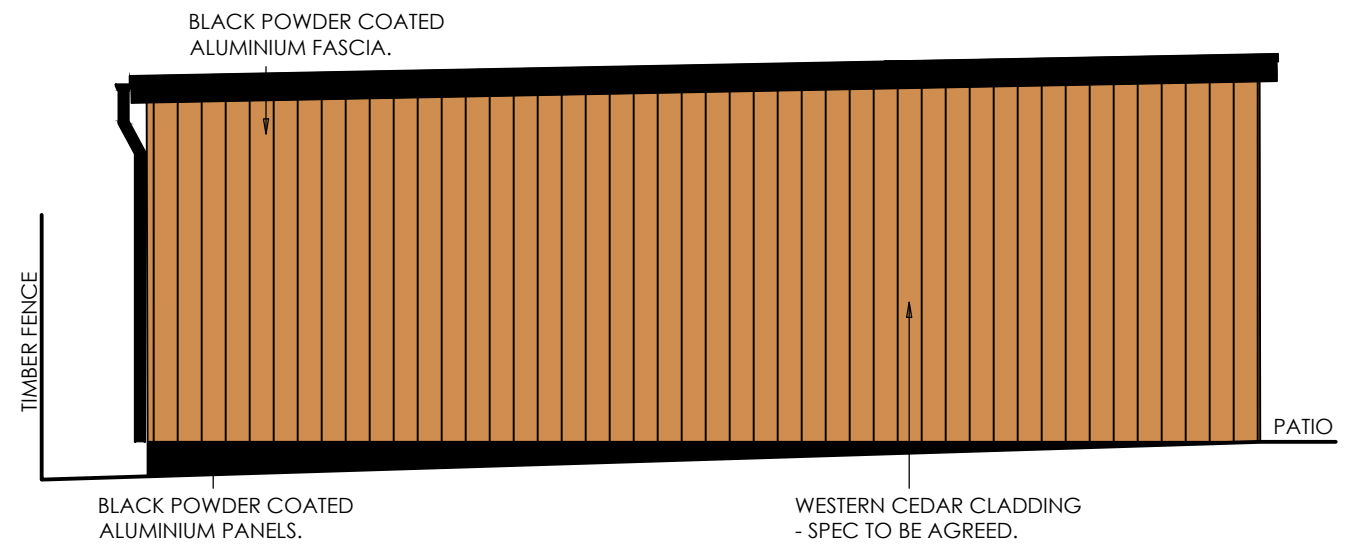


Proposed Side Elevation

Scale 1:25 @ A1 & 1:50 @ A3

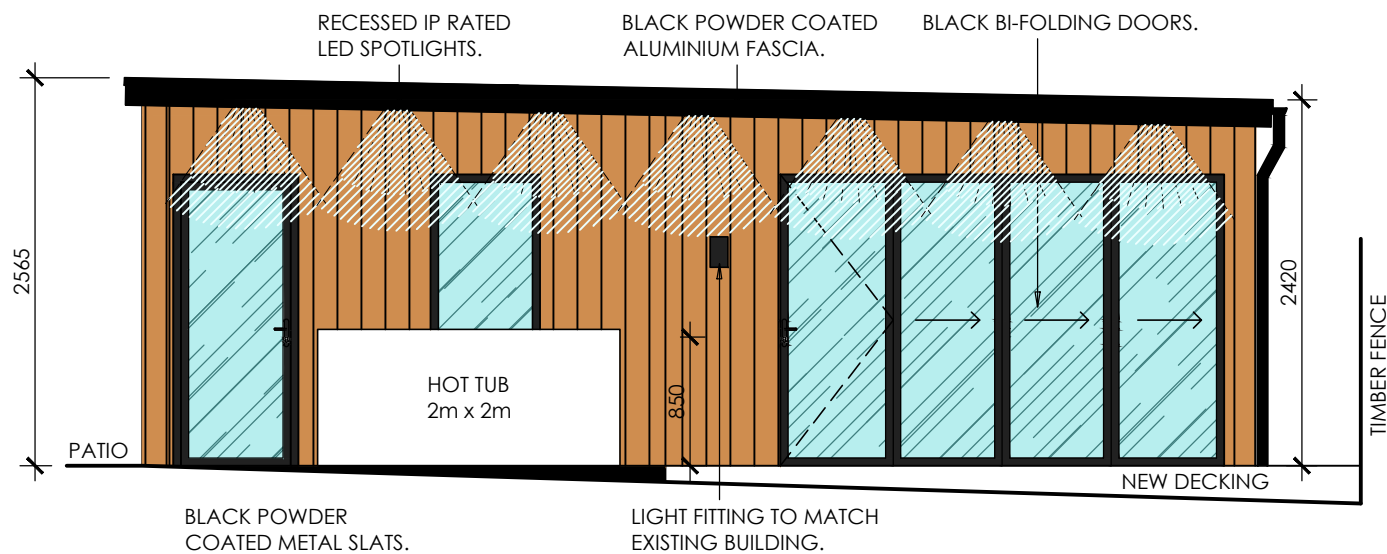

Proposed Side Elevation

Scale 1:25 @ A1 & 1:50 @ A3

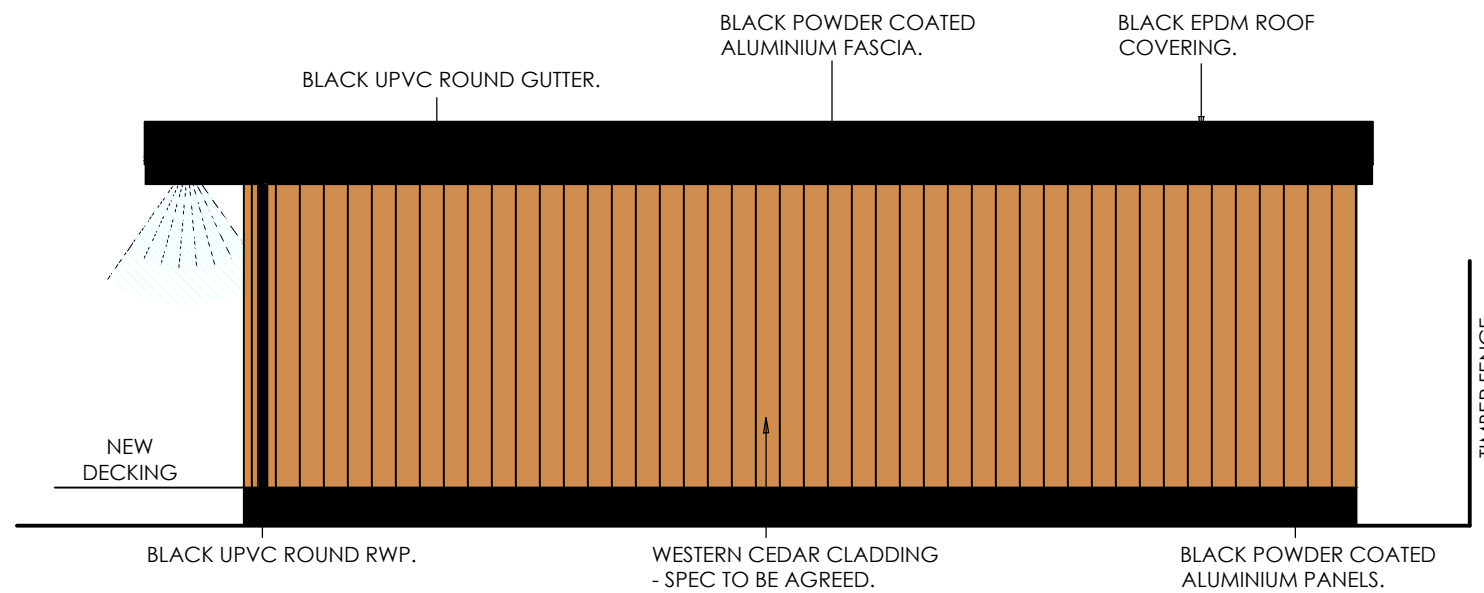

Proposed Back Elevation

Scale 1:25 @ A1 & 1:50 @ A3

© copyright 2020
 This drawing and the copyrights and patents therein are the designer's property and may not be used or reproduced - only under contract. All rights reserved.

ALL DIMENSIONS TO BE CHECKED ON SITE.
 DO NOT SCALE FROM THIS DRAWING EXCEPT FOR THE PURPOSES OF LOCAL AUTHORITY PLANNING

rev	date	description
B	3/8/21	Updated to show as built on site
A	15/1/21	Updated as per markups

Frank Belshaw
 Building Surveyors Limited

wheatley springs barn, wheatley lane road,
 barrowford, nelson, lancashire, BB9 6QS,
 tel no. (01282) 699668, fax no. (01282) 602447.

address
 8 FOX COVERT CLOSE
 WYNYARD
 COUNTY DURHAM
 TS22 5TT
 client
 Mr B. Edwards

drawing title
PROPOSED ELEVATIONS

drawn by
 JC

date
 08/01/21

scale
 AS INDICATED @ A1

drawing no.
 2021/09/04

revision
 B